CONTRACT NO.	JOB ORDER NO.	INDEX	PLANT NO.	DRAWING NUMBER	SHEET NO.	REV. NO.
	11131061/00	P	C424	CA-289209	02 of 02	01

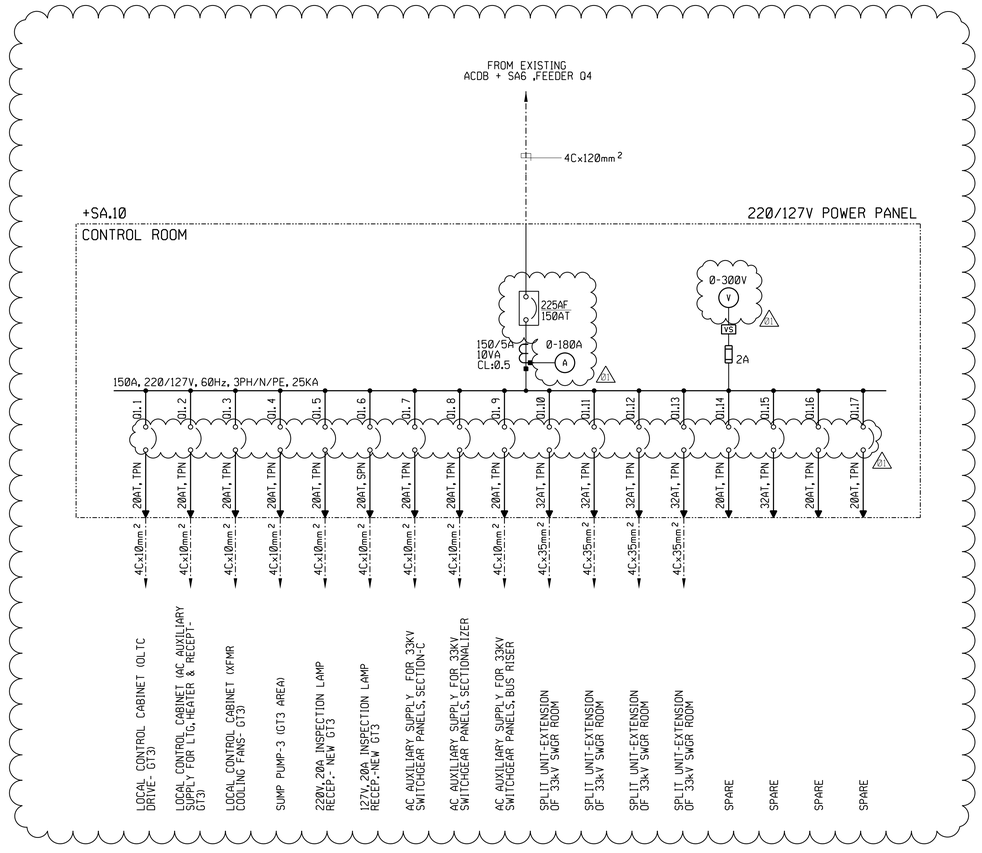

NOTES

1. FOR NOTES AND LEGEND REFER SHEET 01 OF 02.

LEGENDS

NEW POWER PANEL

REFERENCE DRAWINGS

DRAWING TITLE	DRAWING NO.
DRAWING CONTROL SHEET	CE-289148
SCOPE OF WORK & TECHNICAL SPECIFICATION	PTS-11CR143
TENDER SINGLE DIAGRAM	CA-289152
OPERATIONAL SINGLE LINE DIAGRAM	CA-291852
PROTECTION LOGIC DIAGRAM-33kV	CA-289214

AS-BUILT BY _____ DATE _____

REV. NO.	DATE	BY	DESCRIPTION	CHKD.	CERT.	APPD.
01	08/10/13	RGC	REVISED AS PER SEC LETTER REF # 13/19746/3030140I	AN	SSK	
00	30/06/12	RGC	ISSUED FOR APPROVAL	AN	SSK	

DRAWING COMPLETION CERTIFICATE (DCC):

الشركة الوطنية لنقل الكهرباء — نقل الكهرباء National Grid SA

DRAWN BY RGC CHECKED BY AN SCALE: NONE

DATE STARTED JUNE 2012 DATE COMPLETED _____

OPR'G. DEPT. _____ ENG. DEPT. _____

THIS DRAWING IS NOT TO BE USED FOR CONSTRUCTION OR FOR ORDERING MATERIAL UNTIL CERTIFIED AND DATED

CERTIFIED BY _____ DATE _____

ONE LINE DIAGRAM - AC AUXILIARY SYSTEM

REINFORCEMENT OF EXISTING 132/33kV SUBSTATION #8501

AL-MAJMAH SUBSTATION

RIYADH — SAUDI ARABIA

CONTRACT NO.	JOB ORDER NO.	INDEX	PLANT NO.	DRAWING NUMBER	SHEET NO.	REV. NO.
	11131061/00	P	C424	CA-289209	02 of 02	01

NG-A (2012/01)

DMS VECTOR NGA00

THIS DRAWING AND THE INFORMATION CONTAINED HEREIN ARE THE SOLE PROPERTY OF National Grid SA NO REPRODUCTION IN FULL OR IN PART SHALL BE OBTAINED FROM THIS DOCUMENT WITHOUT THE WRITTEN CONSENT OF ITS OWNER.